

This document is the property of Wiregrass Studio, Inc. and is not to be reproduced or copied in whole or in part. It is only to be used for the project & site specifically identified herein & is not to be used on any other project without written permission from the architect.




DATE	REVISIONS	NO.	DATE	DESCRIPTION
			02/26/2018	SCHEMATIC
			04/11/2018	DESIGN
			04/25/2018	PRICING SET
			09/27/2018	PERMIT SET
			CONSTRUCTION 10/09/2018	AS-BUILT

CEDAR LODGE ON HONEY CREEK
560 GA EPISCOPAL CENTER ROAD, CAMDEN
COUNTY, GA
ARCHITECTURAL MASTER PLAN

Date: 1/22/2020
Project No. 1628

AS100

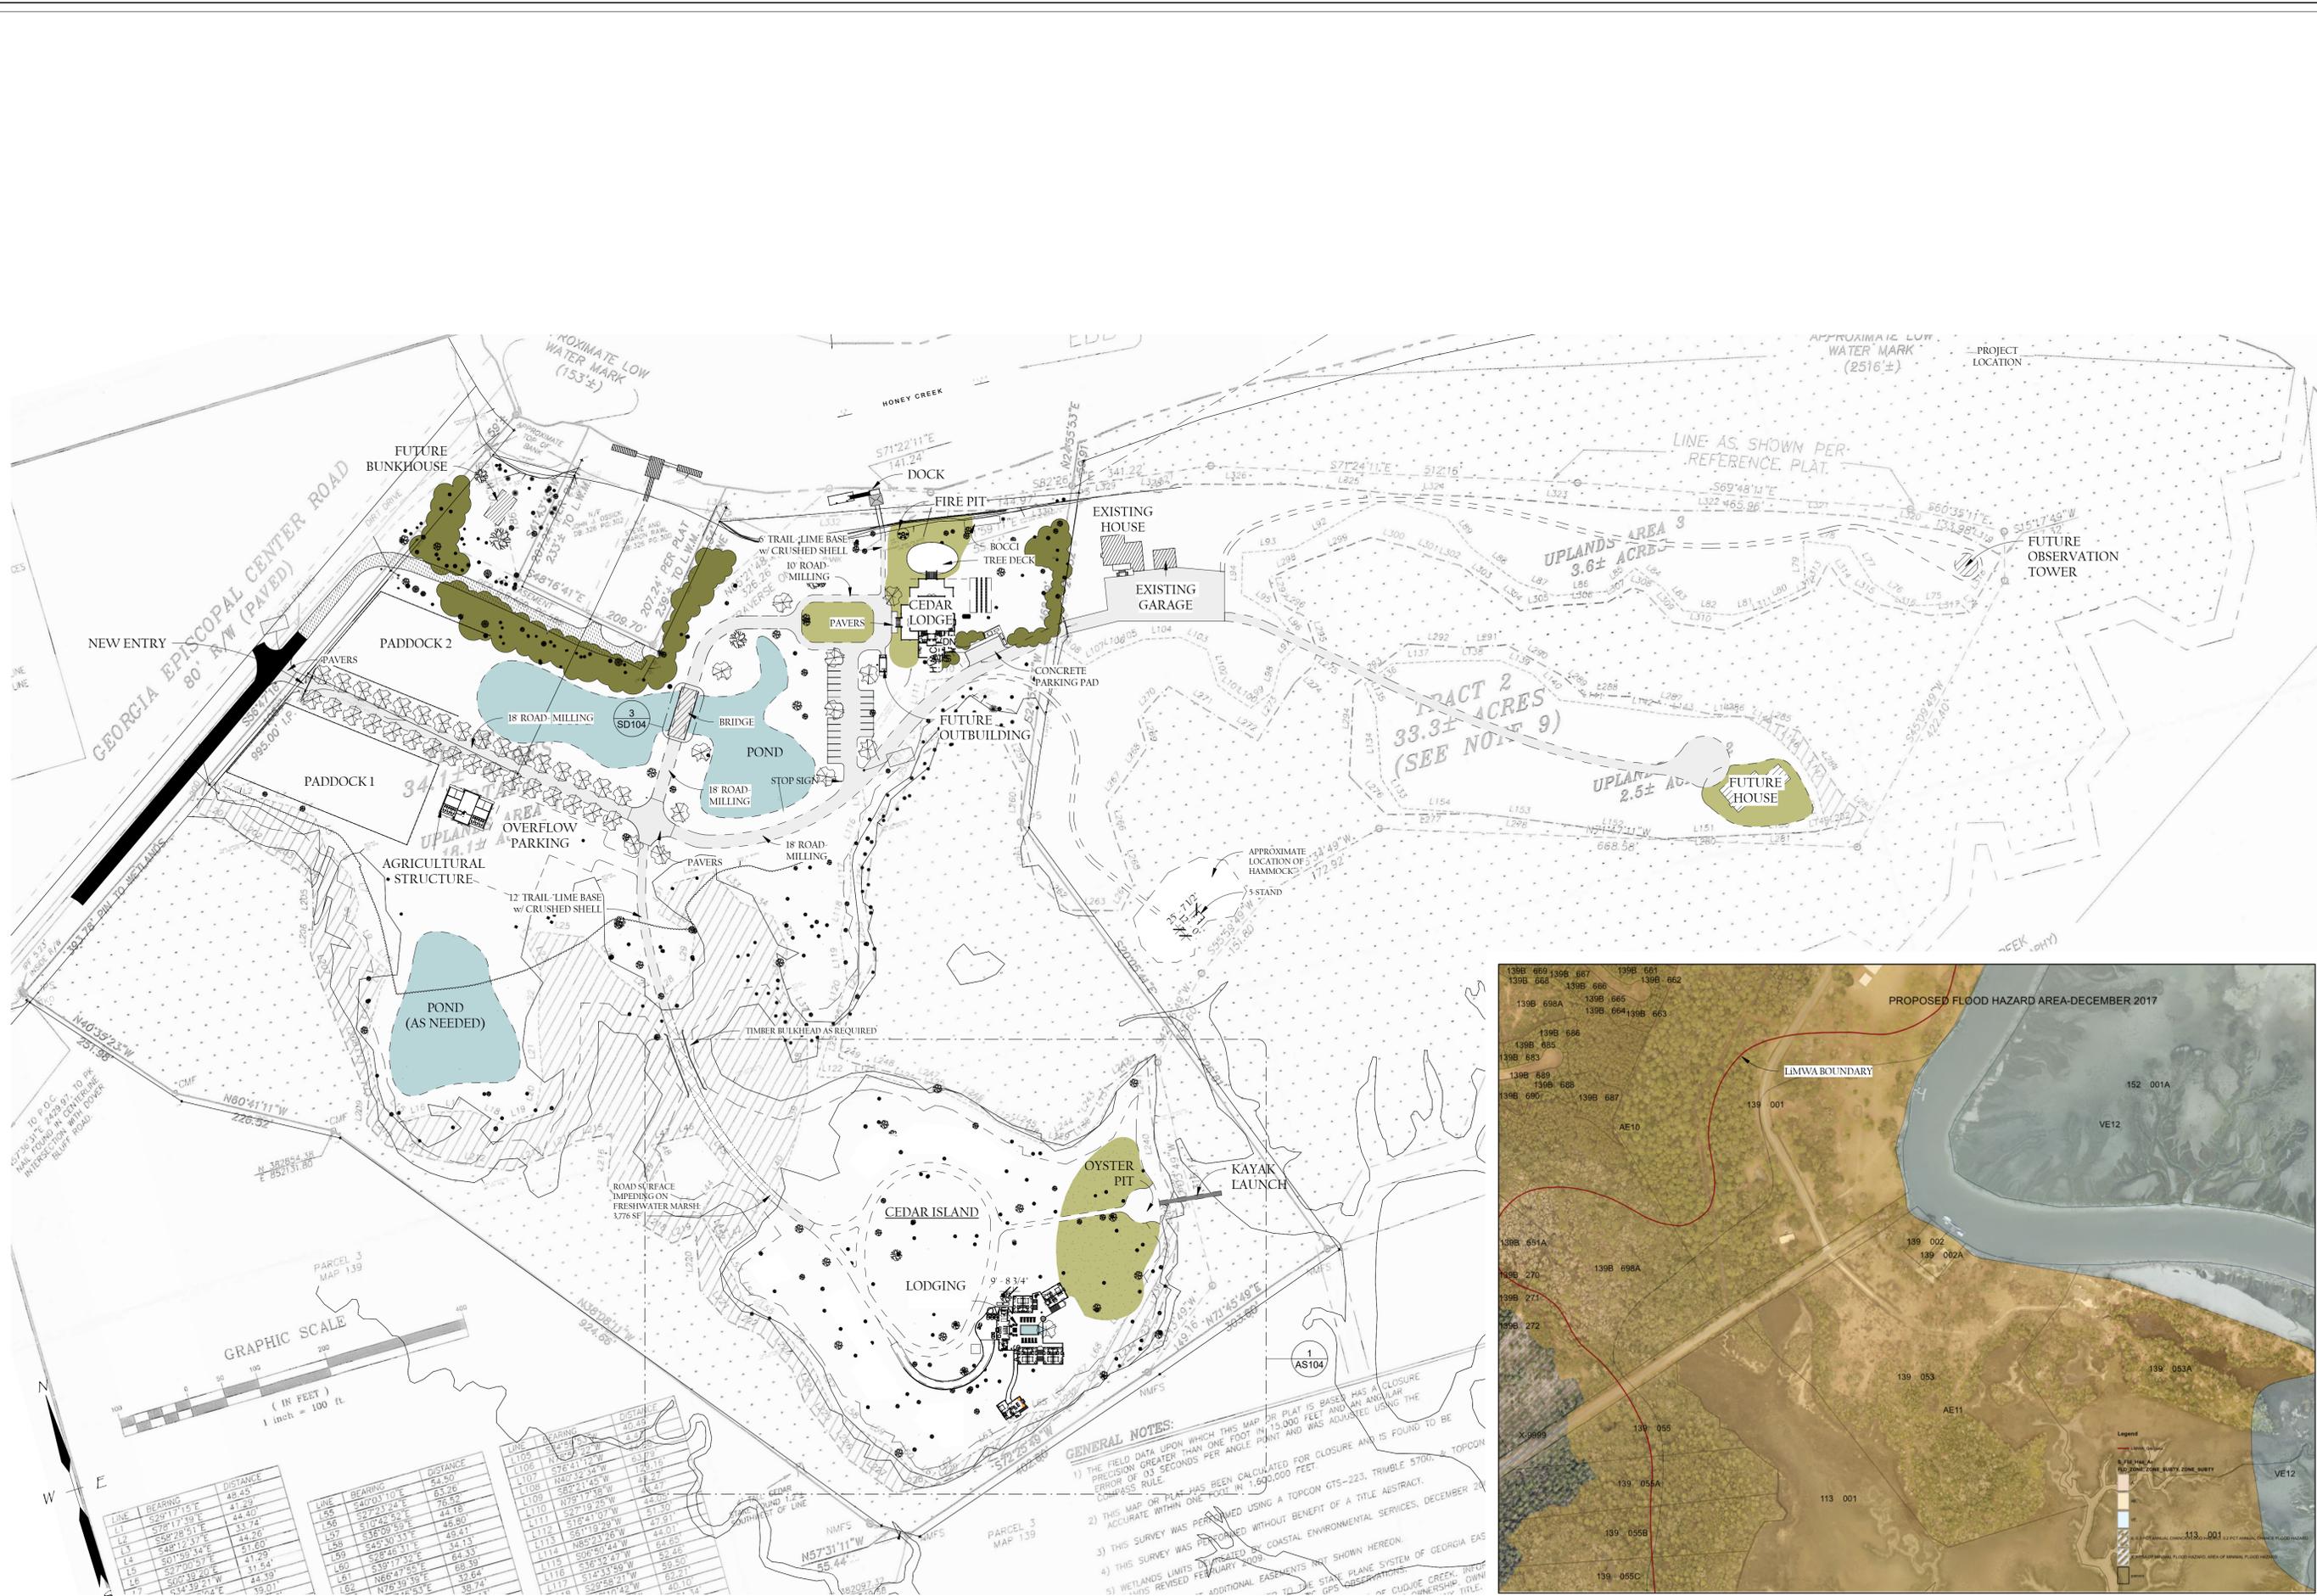

MASTER PLAN
SCALE: 1"=100'-0"

7/28/2020 10:31:51 AM